


*** DIMENSIONS MAY VARY SLIGHTLY IN ACTUAL INSTALLATION - FABRICATION CHANGES OR SUBSTITUTIONS RESERVED ***

AS-BUILT

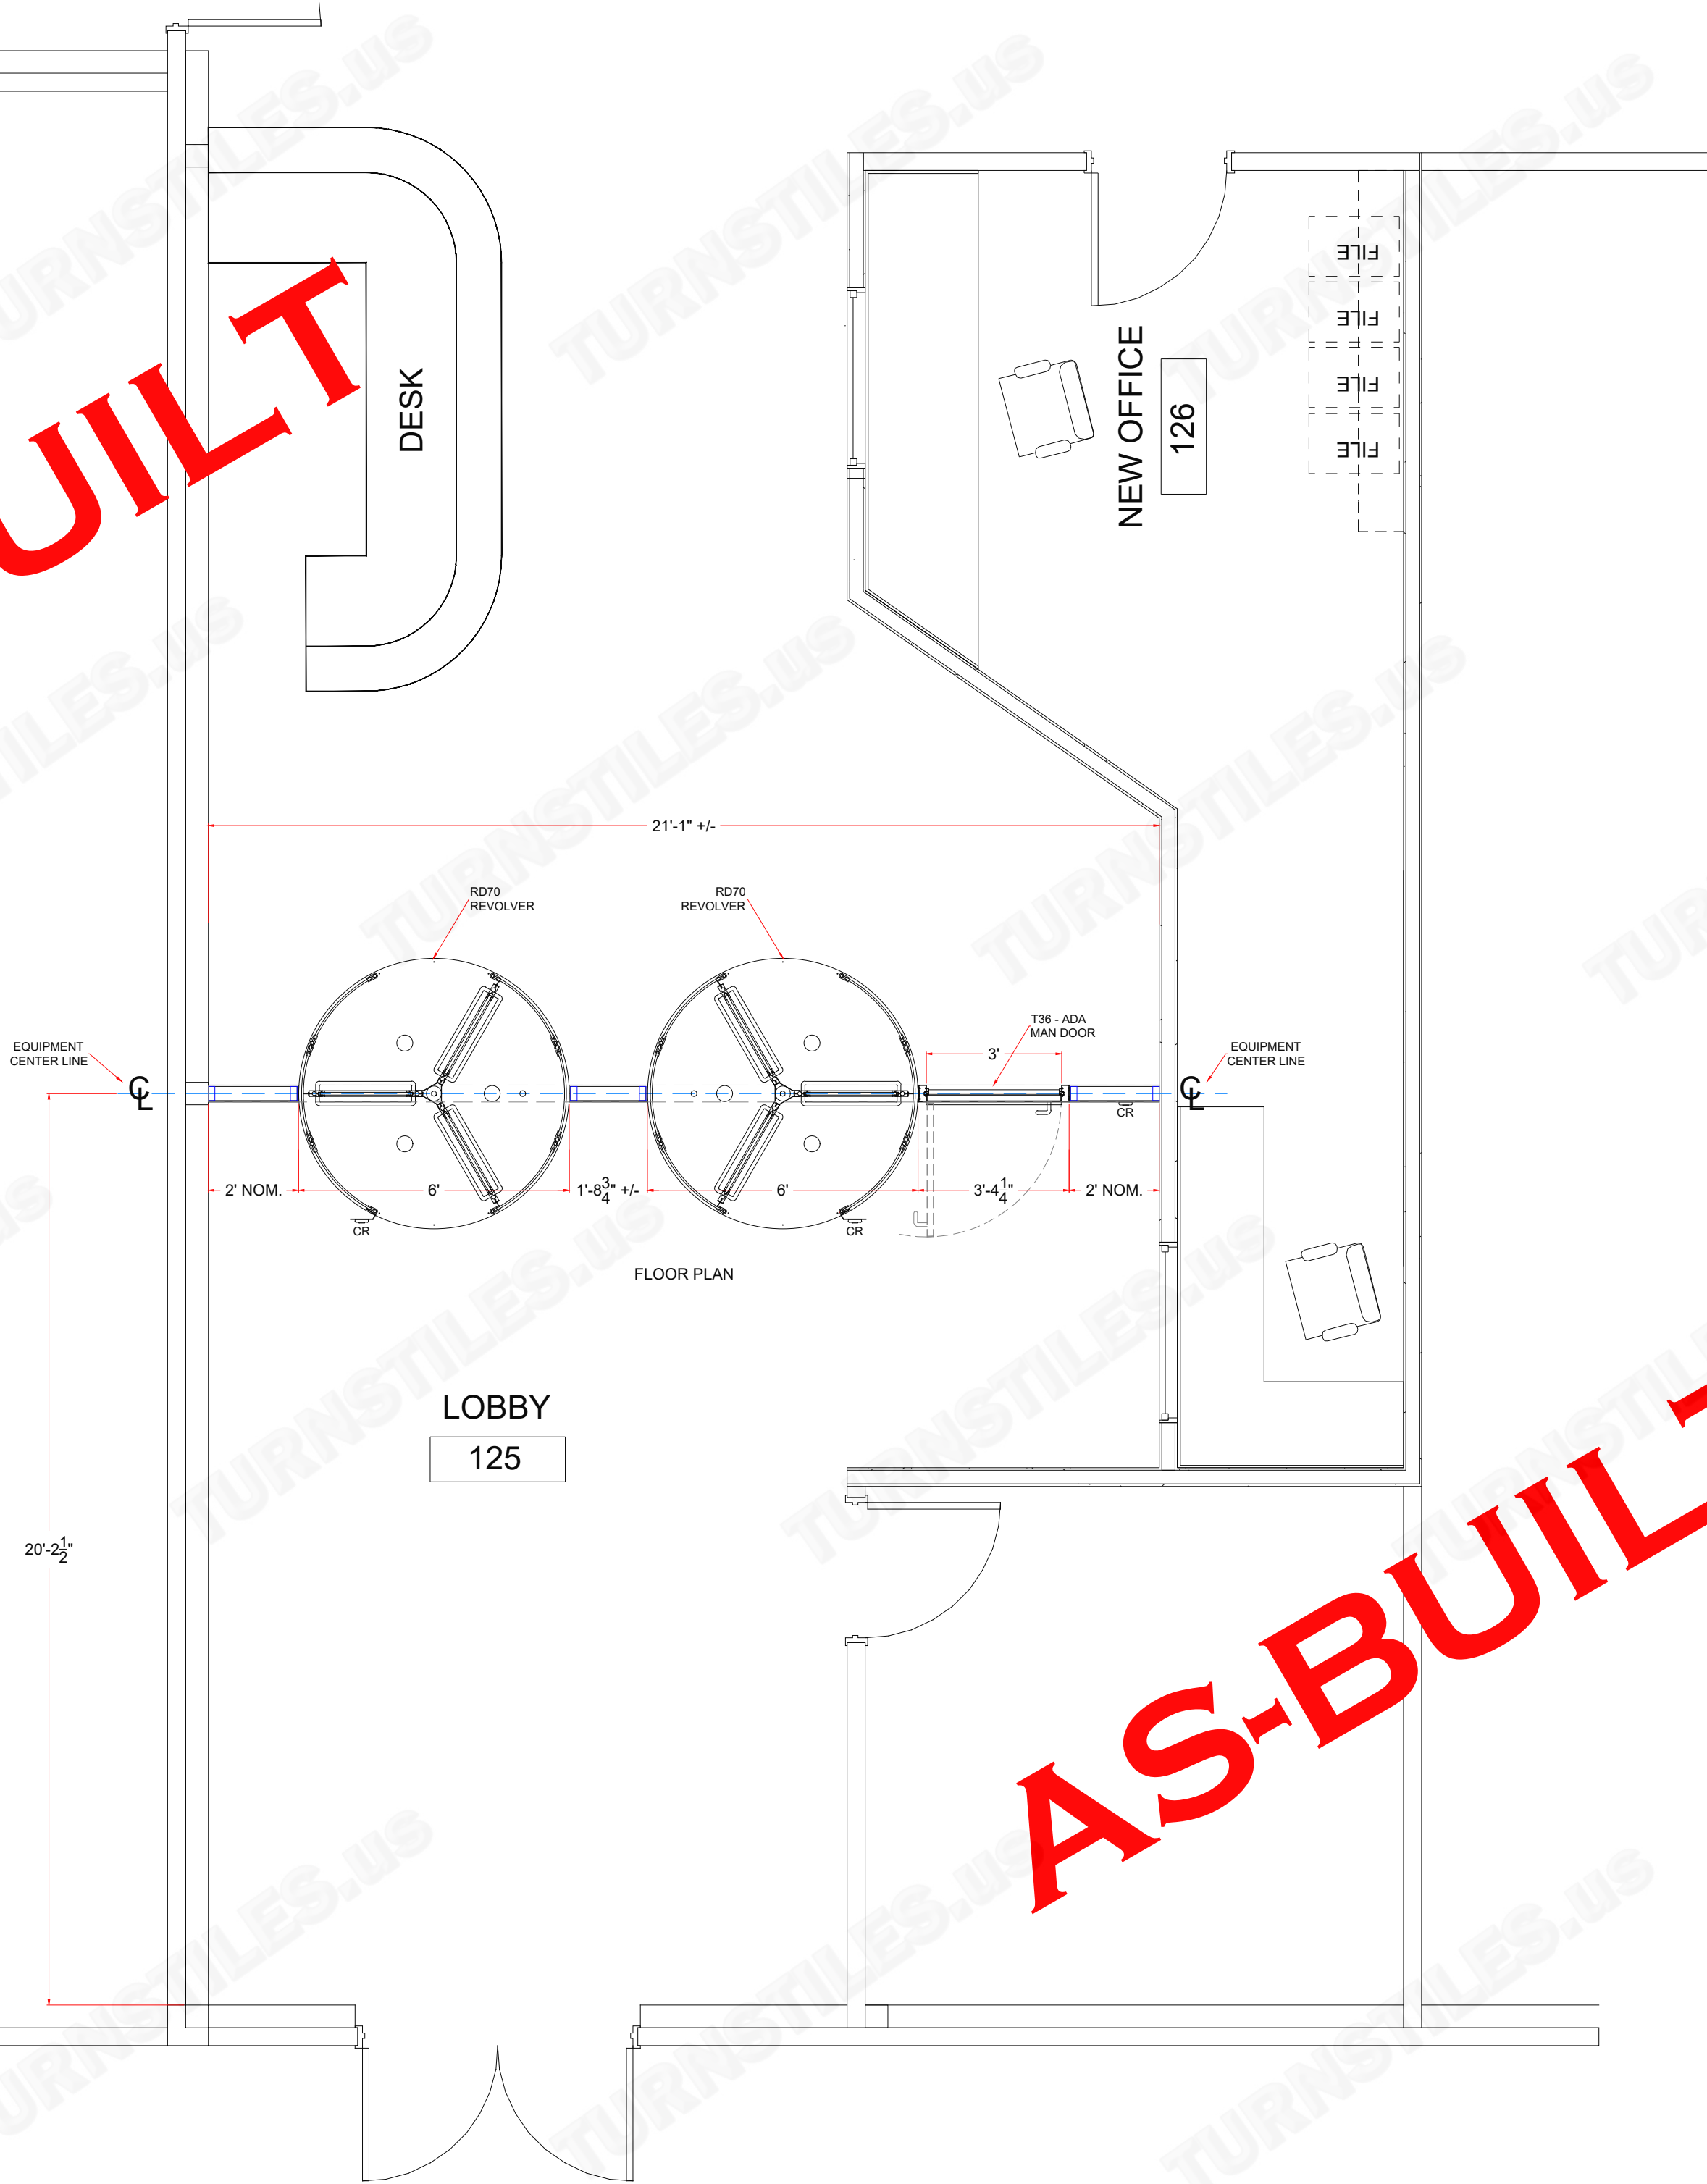

AUTHORIZED SIGNATURE: _____ DATE: ____ / ____ / ____

FIRST DRAWN	BY
01-31-25	CJC
REVISED	BY
12-05-25	CJC
COPYRIGHT © TURNSTILES.US Copyright © Turnstiles.us All rights reserved. Reproduction or translation of this work without the express written permission of TURNSTILES.us is unlawful and is an infringement of intellectual property belonging to TURNSTILES.us. All drawings and/or designs are restricted for use exclusively with a purchase, installation, and/or support from Turnstiles.us. Any other use of these materials is a violation of copyright law. Request for additional information should be addressed to the Legal Department, Turnstiles.us.	



TURNSTILES.us

SECURING THE USA and the GLOBE since 1989

www.TURNSTILES.us
Call: 303-670-1099 | Text: 303-918-9787
patrick.mcallister@turnstiles.us

EQUIPMENT LOCATION DETAIL	
AECOM DENSO Statesville, NC RD70 - T36 ELD AS-BUILT	
DRAWING:	
AECOM Statesville, NC RD70 - T36 ELD AS-BUILT	
DATE:	12-05-25
PAGE:	1 OF 1